


LAKE WASHINGTON PARK

5808 Lake Washington Boulevard | Kirkland, WA

2nd Floor – 7,374 RSF Available

As-Built

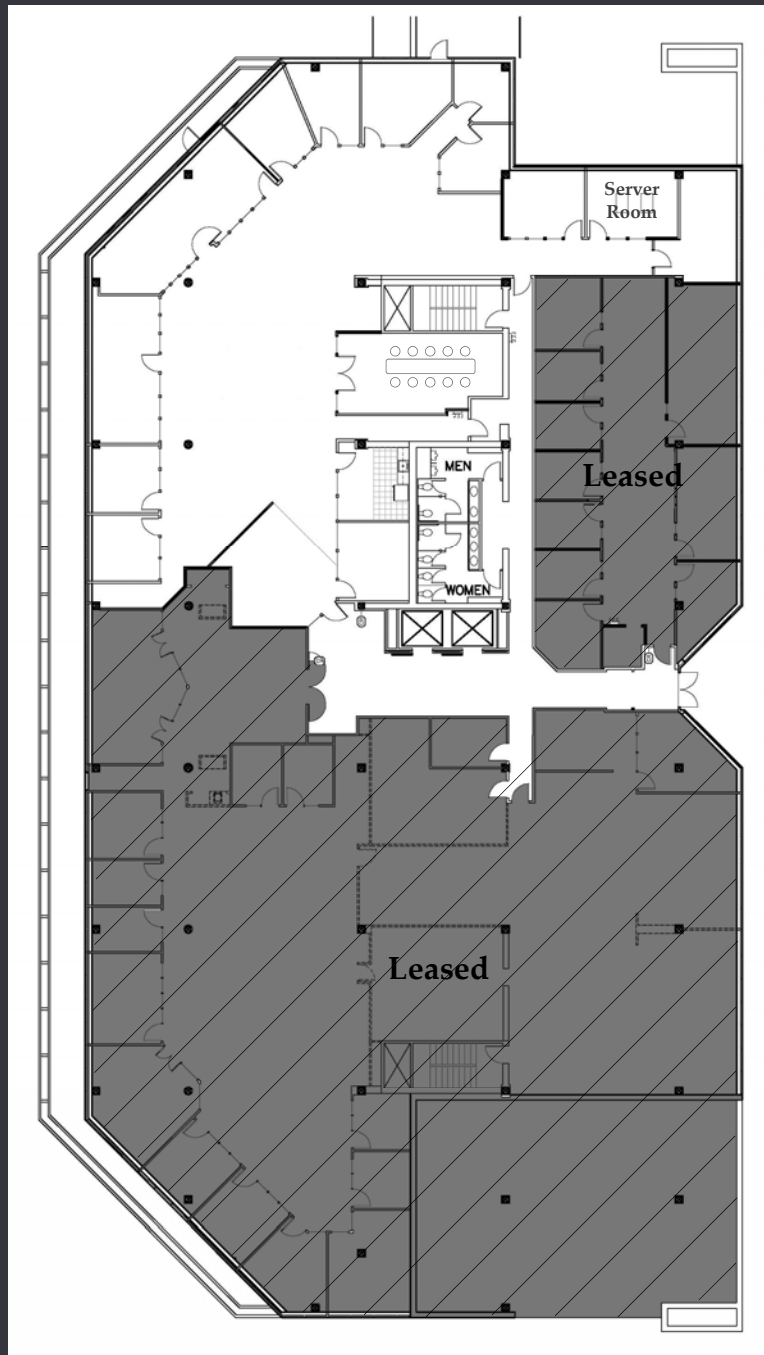

MATT SCHRECK
425.646.5232 | schreck@broderickgroup.com

GRANT YERKE
425.646.5264 | yerke@broderickgroup.com