

LINCOLN SQUARE

LINCOLN SQUARE NORTH

10401 NE 8th

Bellevue, WA 98004



BRODERICK
GROUP

For more information or to
schedule a tour, please contact:

PAUL SWEENEY
425.646.5225

sweeney@broderickgroup.com

JIM KINERK
425.646.5221

kinerk@broderickgroup.com

CLAYTON HOLM
425.274.4287

holm@broderickgroup.com

LINCOLN SQUARE NORTH


Floor 22 • 22,403 RSF • As-Built Plan

SPACE FEATURES

- Available 4/1/2027
- Unobstructed Lake Washington and Seattle Skyline views
- Former Microsoft floor



APPROXIMATE WEST VIEW

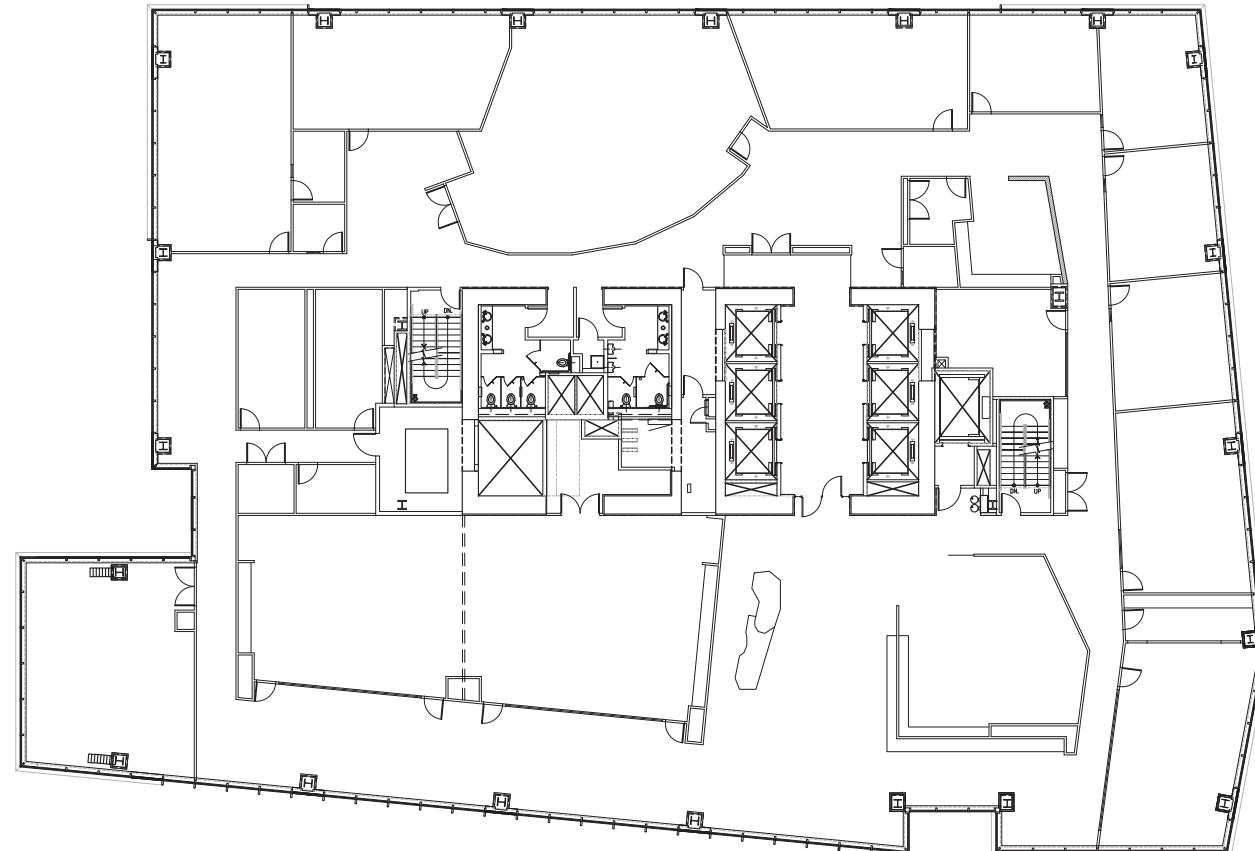

[BACK TO AVAILABILITIES](#)