


# MADISON CENTRE

920 5TH AVENUE | SEATTLE, WA 98104

**FLOOR 14 | AS-BUILT**  
21,945 RSF  
AVAILABLE NOW

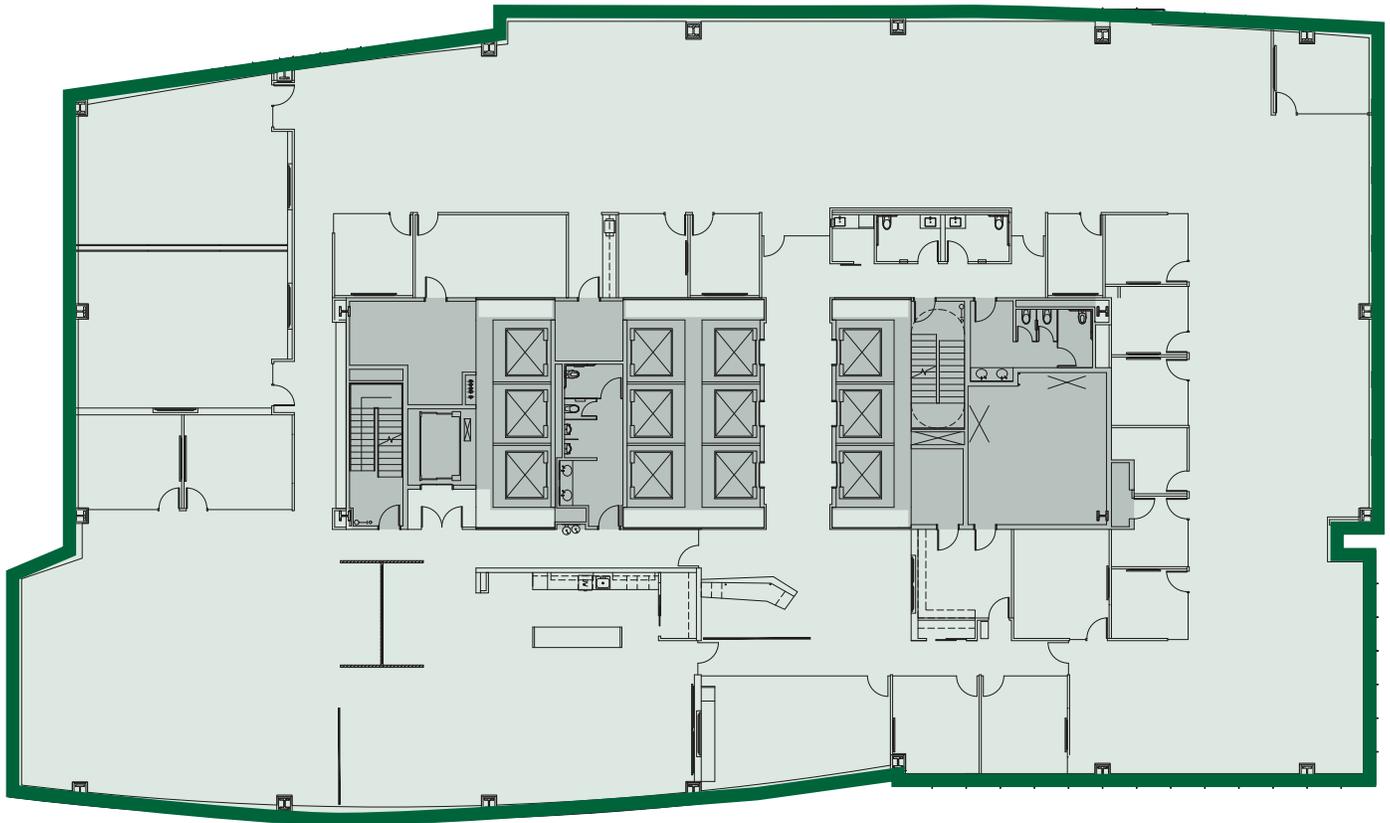

CLICK TO TAKE A  
VIRTUAL TOUR



Please contact exclusive leasing agents for  
more details and to schedule a tour.

DAMON MCCARTNEY | (206) 838-7633  
mccartney@broderickgroup.com

DAVID GREENWOOD | (206) 838-7635  
greenwood@broderickgroup.com

**bxp**

**BRODERICK**  
GROUP