

MADISON CENTRE


920 5TH AVENUE | SEATTLE, WA 98104

FLOOR 16 | AS-BUILT

2,295 - 6,841 RSF
AVAILABLE Q3 2026

SUITE 1610
2,425 RSF

SUITE 1620
2,295 RSF

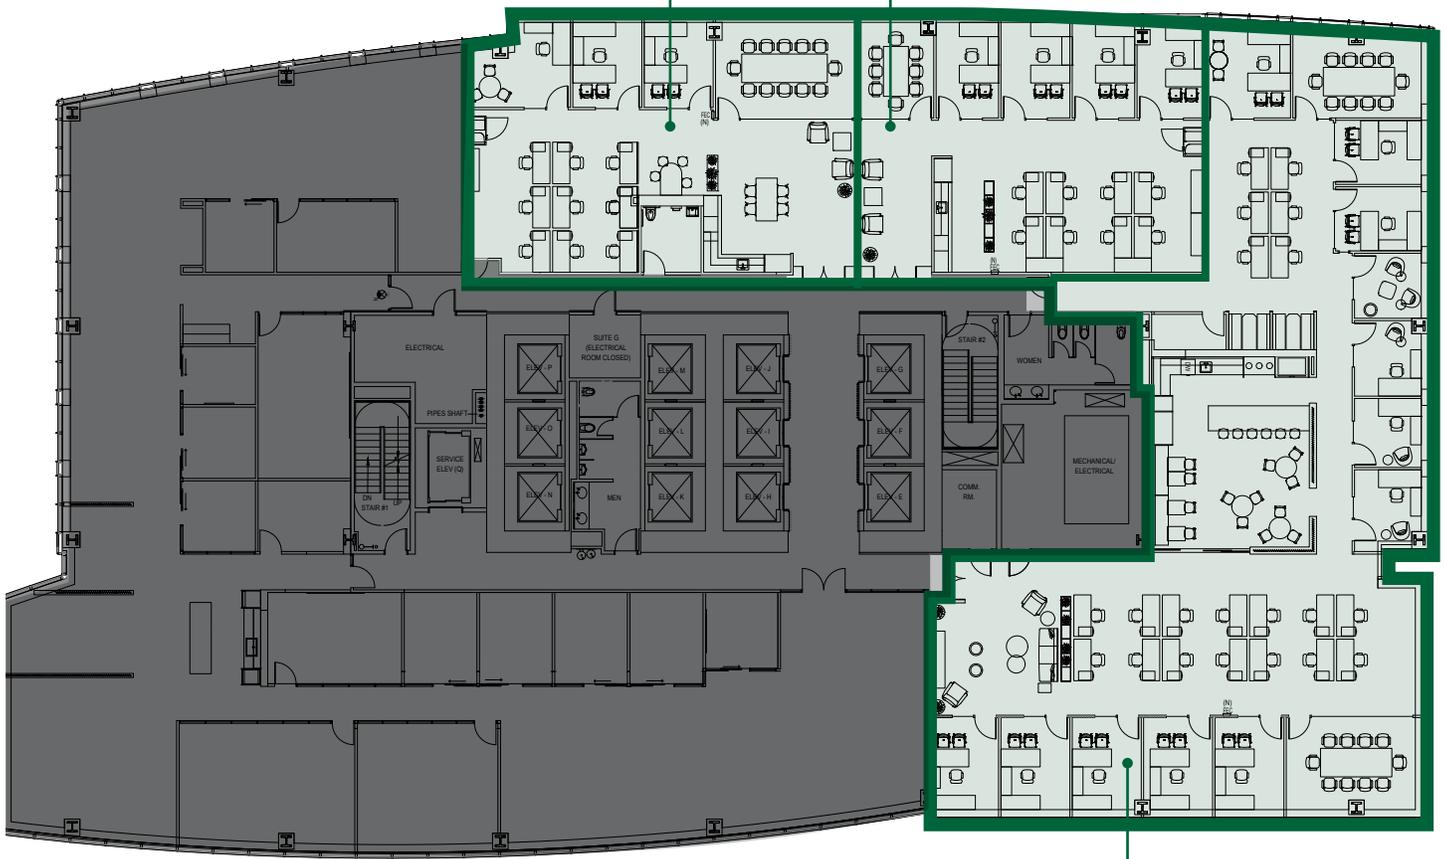

SUITE 1630
6,841 RSF



Please contact exclusive leasing agents for more details and to schedule a tour.

DAMON MCCARTNEY | (206) 838-7633
mccartney@broderickgroup.com

DAVID GREENWOOD | (206) 838-7635
greenwood@broderickgroup.com

bxp

BRODERICK
GROUP