

LINCOLN SQUARE

LINCOLN SQUARE NORTH

10401 NE 8th
Bellevue, WA 98004



BRODERICK
GROUP

For more information or to
schedule a tour, please contact:

PAUL SWEENEY
425.646.5225
sweeney@broderickgroup.com

JIM KINERK
425.646.5221
kinerk@broderickgroup.com


CLAYTON HOLM
425.274.4287
holm@broderickgroup.com

LINCOLN SQUARE NORTH

Floor 9 • 21,942 RSF • As-Built Plan

SPACE FEATURES

- Available now
- Unobstructed Lake Washington and Seattle Skyline views
- Former Microsoft floor

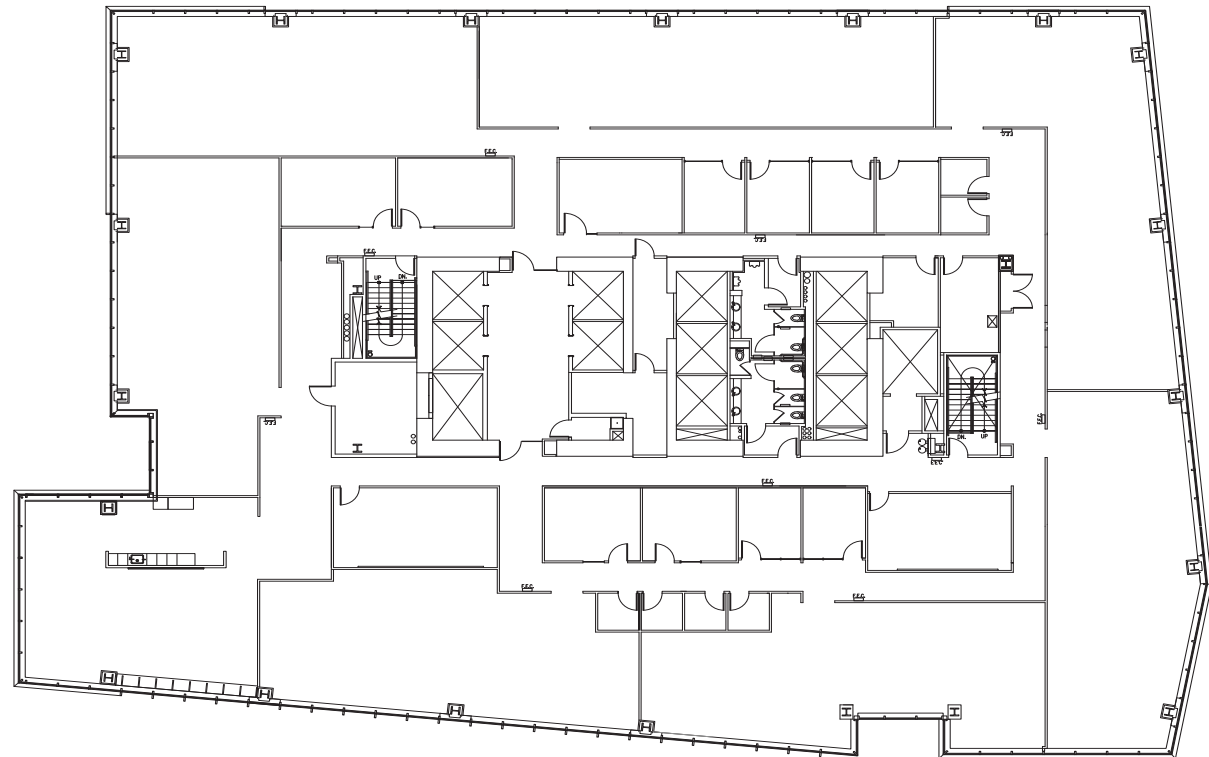

[BACK TO AVAILABILITIES](#)

LINCOLN SQUARE

LINCOLN SQUARE NORTH

10401 NE 8th
Bellevue, WA 98004

BRODERICK
GROUP

For more information or to
schedule a tour, please contact:

PAUL SWEENEY
425.646.5225
sweeney@broderickgroup.com

JIM KINERK
425.646.5221
kinerk@broderickgroup.com


CLAYTON HOLM
425.274.4287
holm@broderickgroup.com

LINCOLN SQUARE NORTH

Floor 9 • 21,942 RSF • Furniture Plan

SPACE FEATURES

- Available now
- Unobstructed Lake Washington and Seattle Skyline views
- Former Microsoft floor

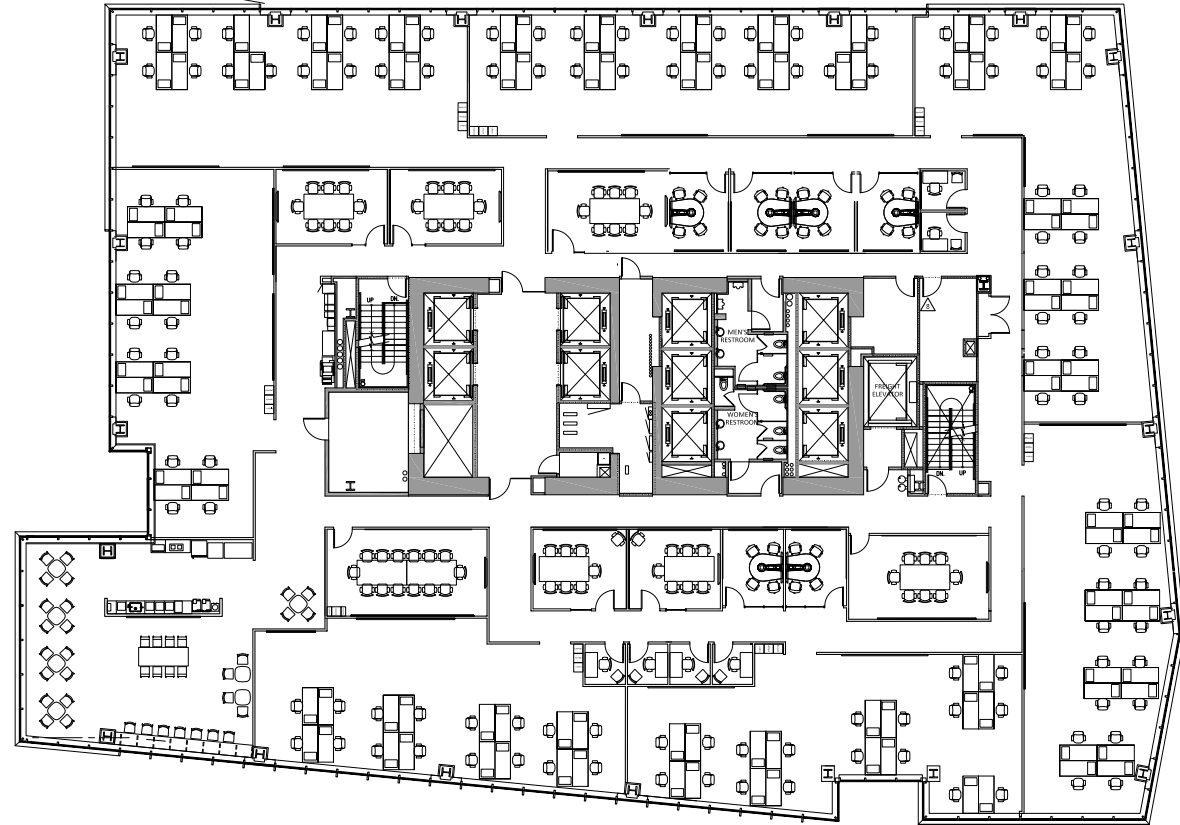

[BACK TO AVAILABILITIES](#)