


# MADISON CENTRE

920 5TH AVENUE | SEATTLE, WA 98104

**FLOOR 16 | AS-BUILT**  
22,380 RSF

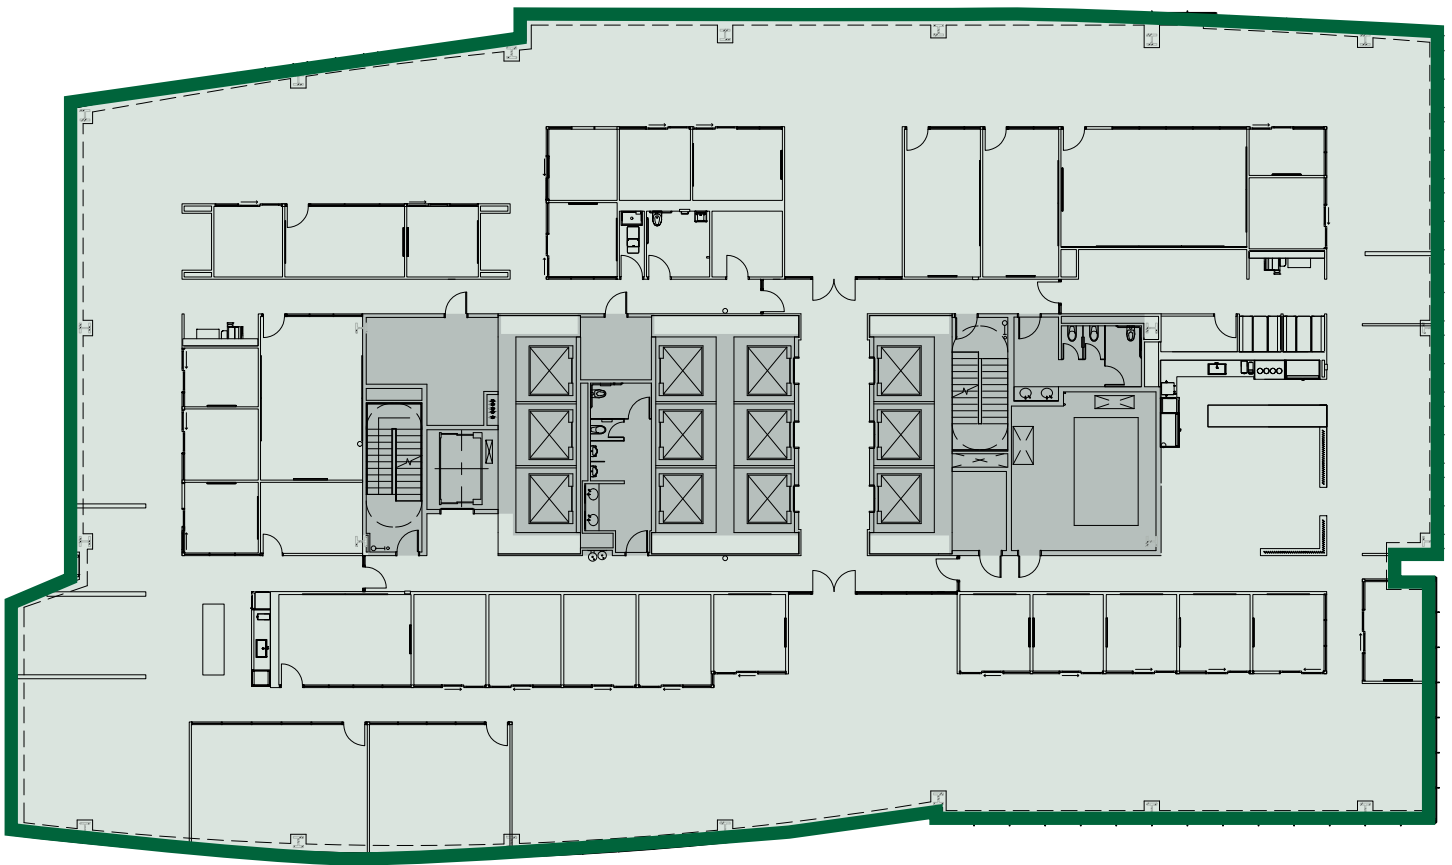

CLICK TO TAKE A  
VIRTUAL TOUR

Please contact exclusive leasing agents for  
more details and to schedule a tour.

**DAMON MCCARTNEY** | (206) 838-7633  
mccartney@broderickgroup.com

**DAVID GREENWOOD** | (206) 838-7635  
greenwood@broderickgroup.com

**bxp**

**BRODERICK**  
· GROUP ·