


BUILDING III

FLOOR 1

As-Built Floor Plan

Suites 110 & 120 contiguous
for a total of 22,650 RSF

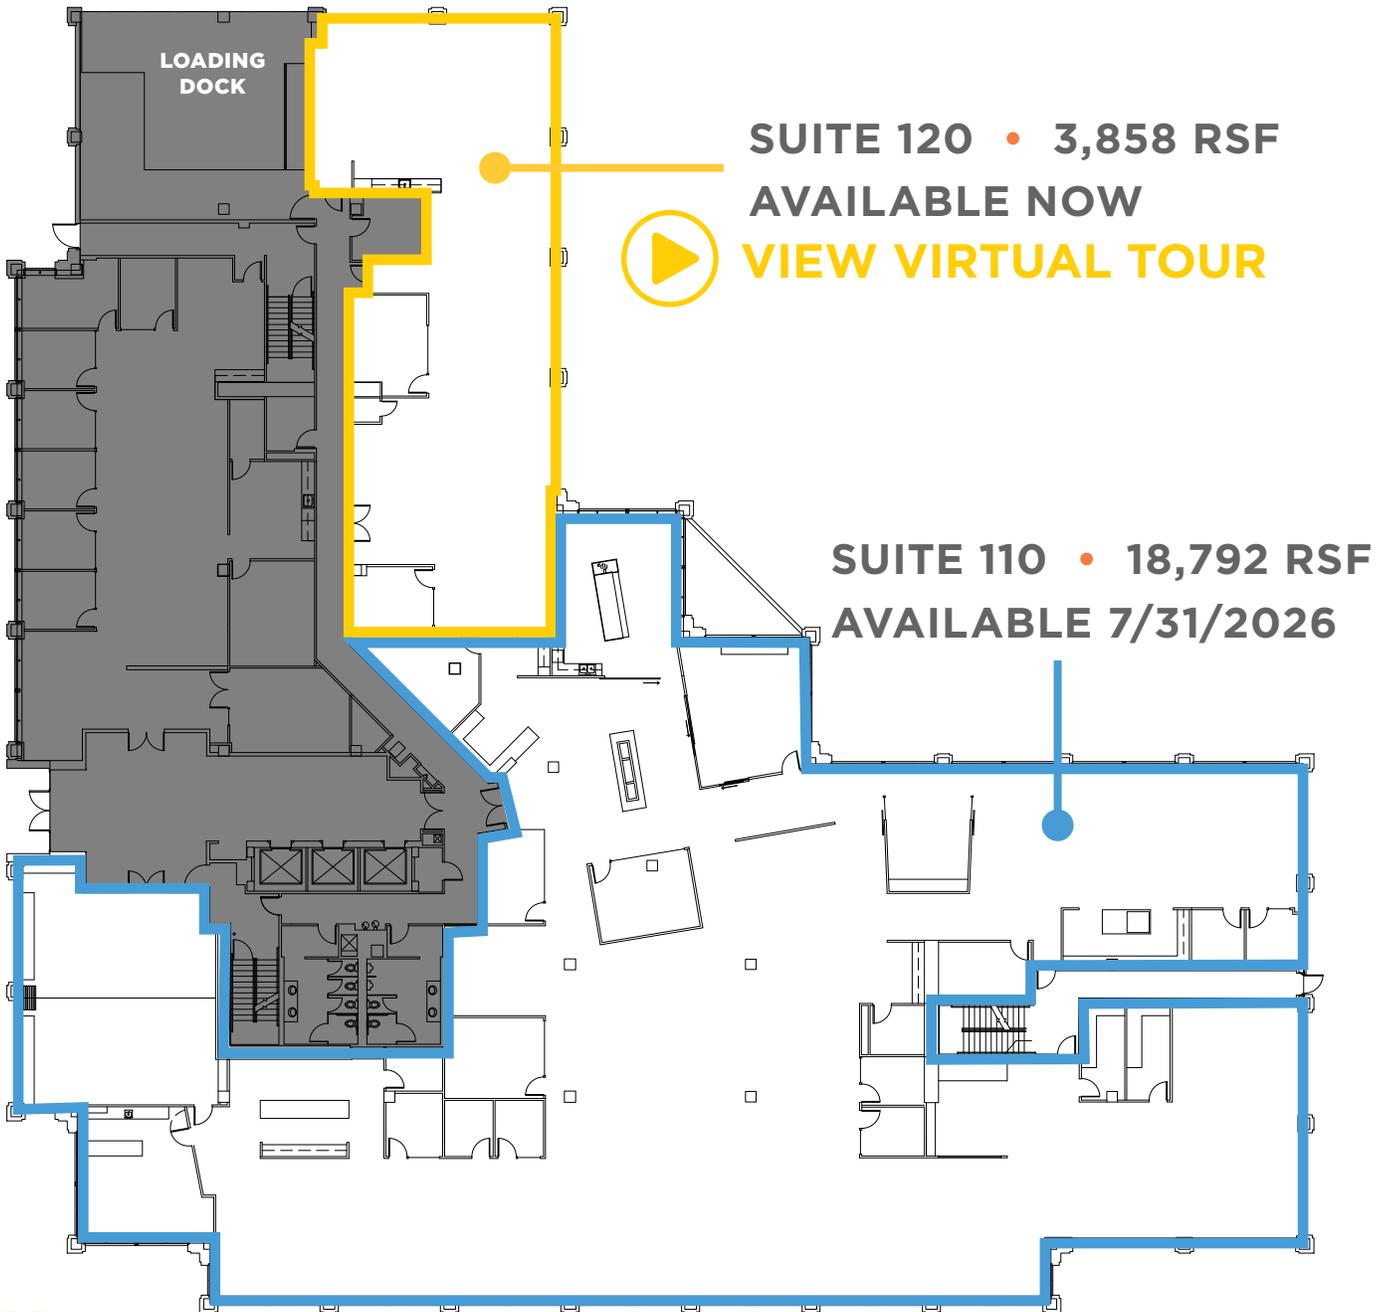

BRODERICK GROUP, INC.

[Jason Furr](#) • [Tony Ulacia](#)

425.646.3444

The information contained herein has been given to us by the owner or sources that we deem reliable. We have no reason to doubt its accuracy, but we do not guarantee it. Prospective tenants should carefully verify all information contained herein.