

Suite 500


East Building / 30,655 RSF / Sample Plan

Views of Cascade Mountains, Mount Rainier, and Bellevue CBD

Full Floor

Contiguous with Suite 600 for a total of 55,646 RSF

[▶ CLICK TO VIEW VIRTUAL TOUR](#)

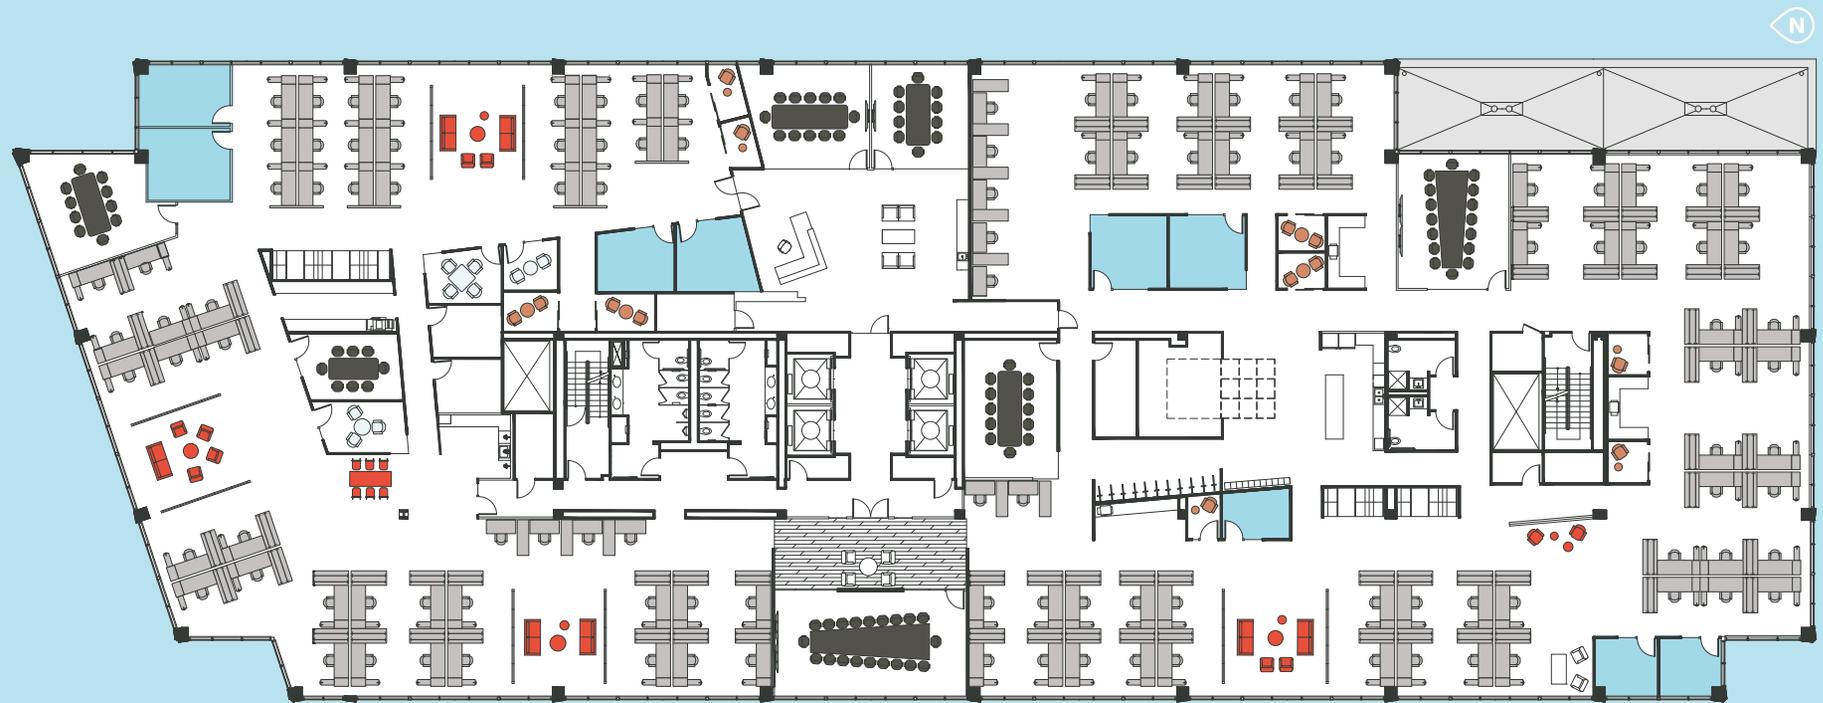

- HUDDLE ROOM
- WORK LOUNGE
- OFFICE/MEETING
- OPEN OFFICE
- CONFERENCE ROOM
- PHONE ROOM

Suite 500

East Building / 30,655 RSF / As-Built Plan

Views of Cascade Mountains, Mount Rainier, and Bellevue CBD

Full Floor

Polished concrete and exposed ceiling off elevator lobby

Contiguous with Suite 600 for a total of 55,646 RSF

[▶ CLICK TO VIEW VIRTUAL TOUR](#)

