

# Suite 600

East Building / 24,991 RSF / Sample Tech Plan


Views of Cascade Mountains, Mount Rainier, and Bellevue CBD

Top Floor / Full Floor

Private Rooftop Deck

Contiguous with Suite 500 for a total of 55,646 RSF

[▶ CLICK TO VIEW VIRTUAL TOUR](#)

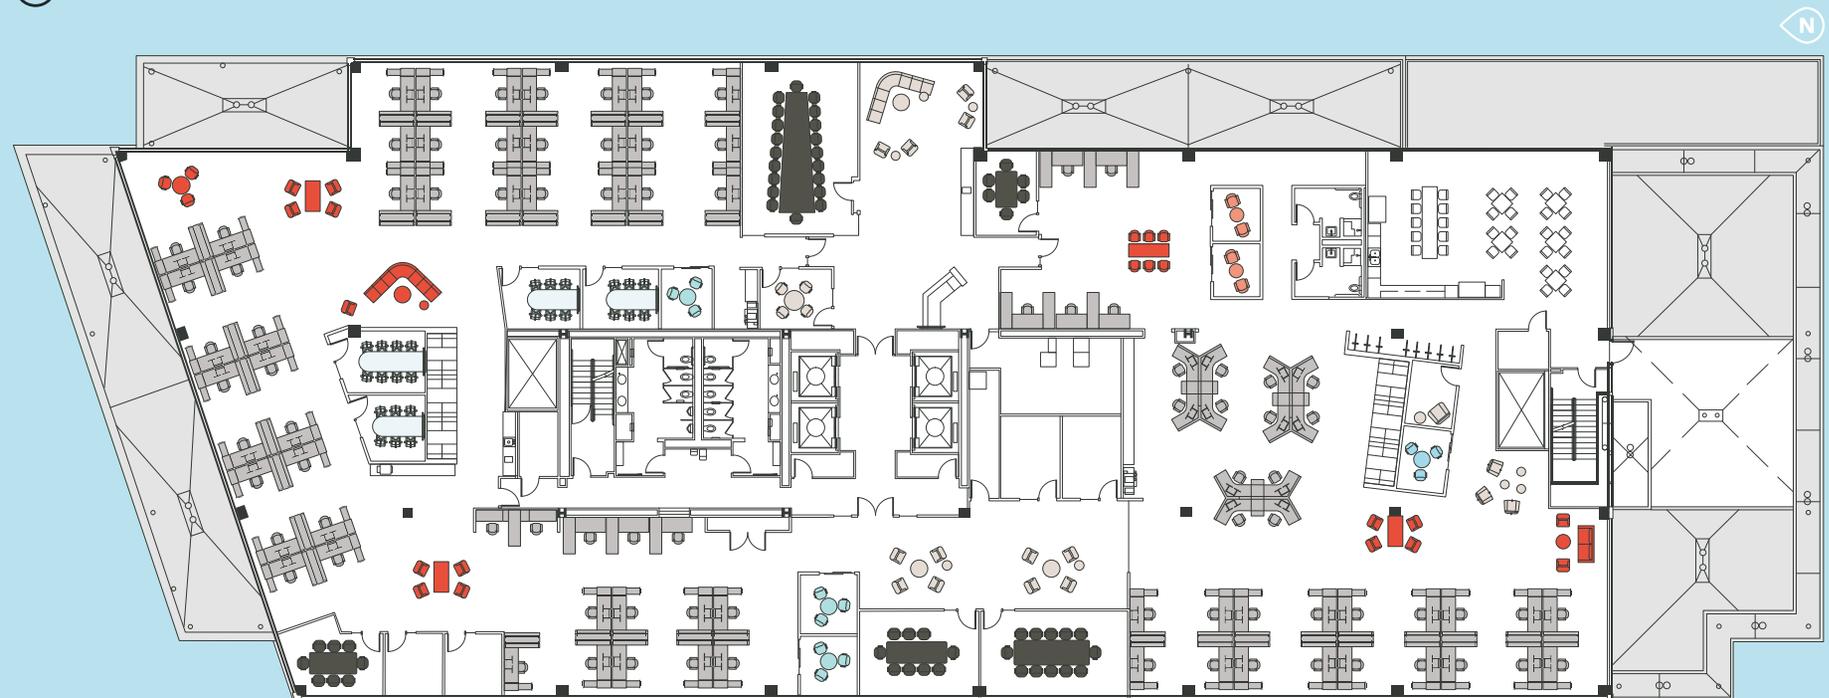

- OPEN COLLABORATION
- OPEN OFFICE
- PHONE ROOM
- FOCUS ROOM
- HUDDLE ROOM
- CONFERENCE ROOM

# Suite 600

East Building / 24,991 RSF / As-Built Plan

Views of Cascade Mountains, Mount Rainier, and Bellevue CBD

Top Floor / Full Floor

Private Rooftop Deck

Contiguous with Suite 500 for a total of 55,646 RSF

[▶ CLICK TO VIEW VIRTUAL TOUR](#)

