

PLAZA @ NORTH CREEK

EAST BUILDING

18911 NORTH CREEK PKWY
BOTHELL, WA

TYLER SLONE

425.274.4281

slone@broderickgroup.com

PAUL JERUE

425.646.5223


jerue@broderickgroup.com

BRODERICK
• GROUP •


FLOOR PLAN

SUITE 200 | 10,409 RSF | AVAILABLE NOW

SAMPLE PLAN

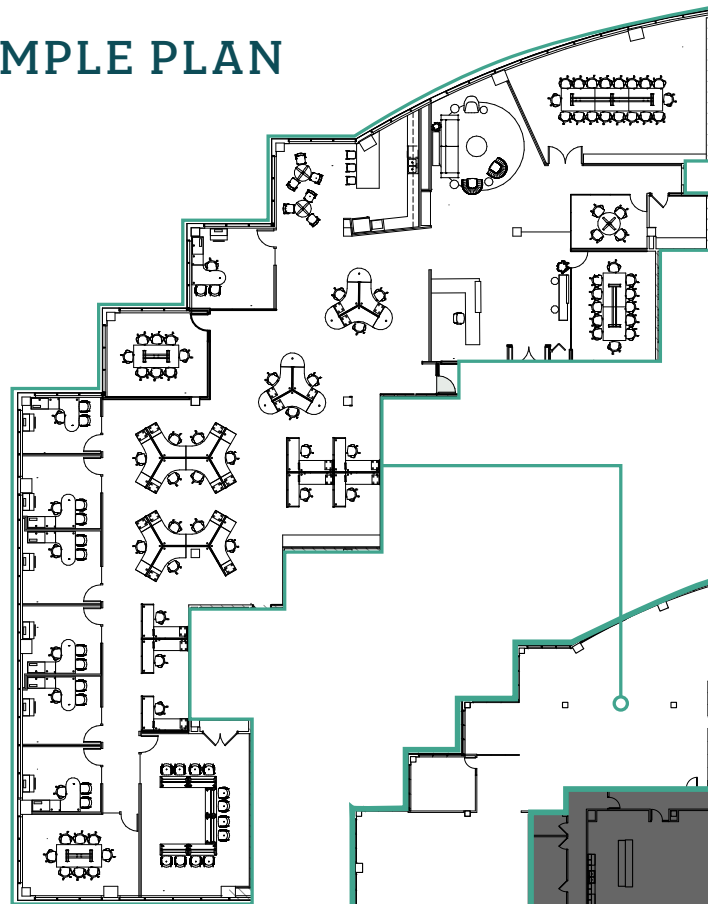

AS-BUILT

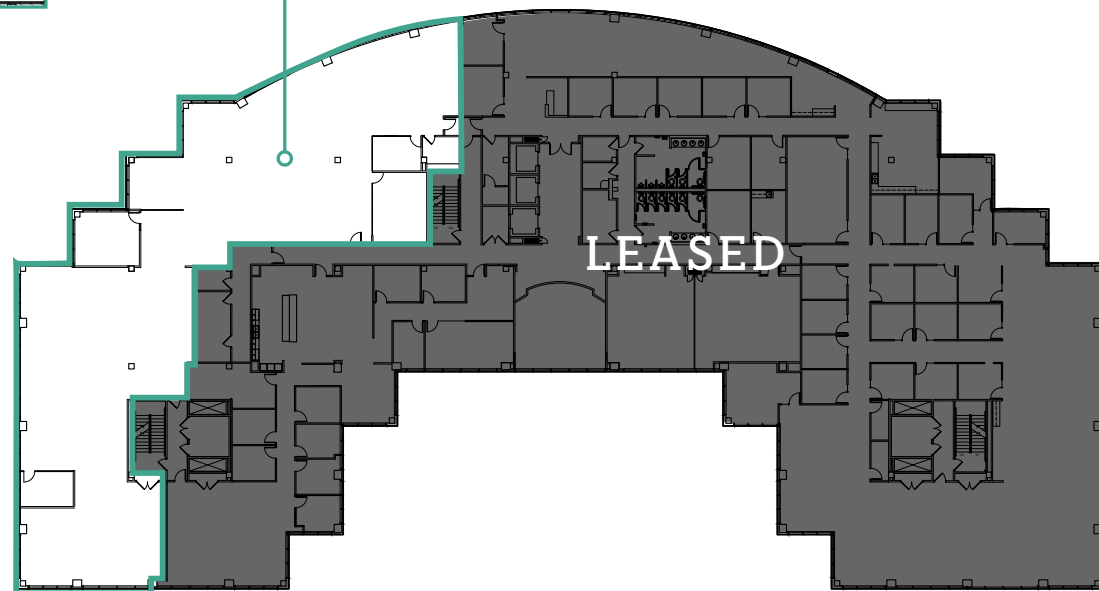

LEASED

