


# SOUTH TOWER | SUITE 500 | 23,992 RSF

AS-BUILT

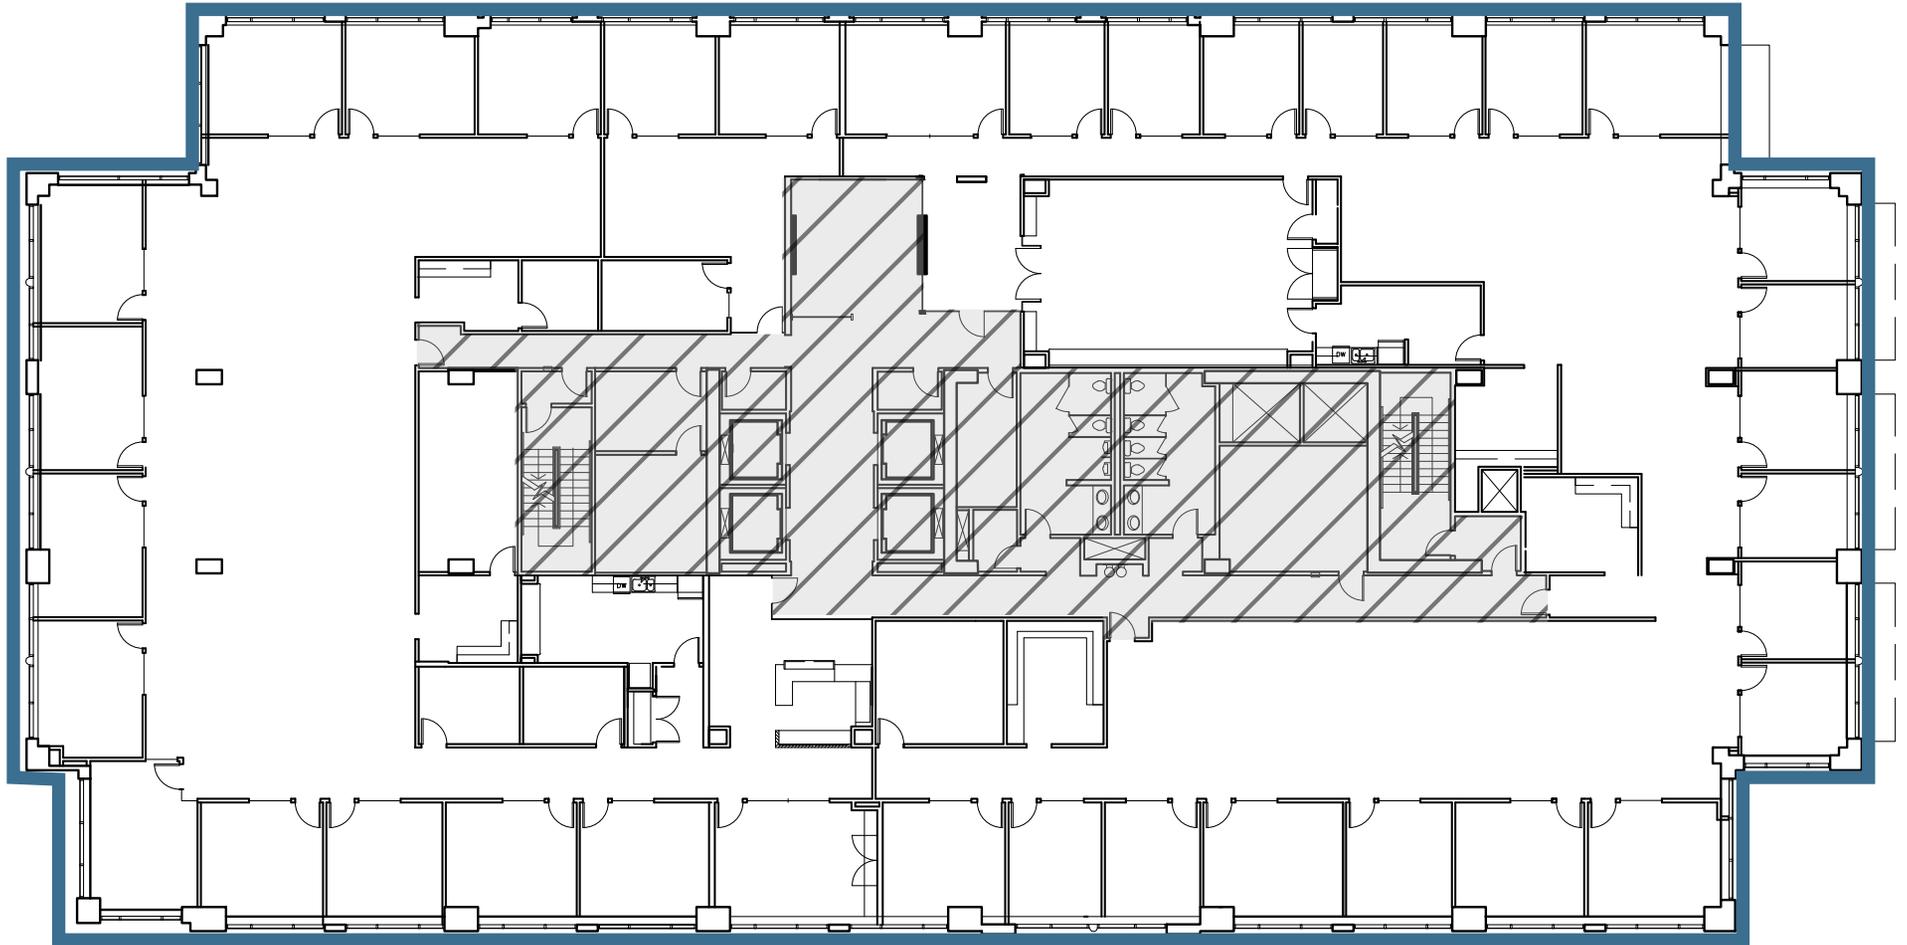

# SOUTH TOWER | SUITE 500 | 23,992 RSF

PROPOSED - TWO TENANT

