


SOUTH TOWER | SUITE 600 | 23,778 RSF

AS-BUILT

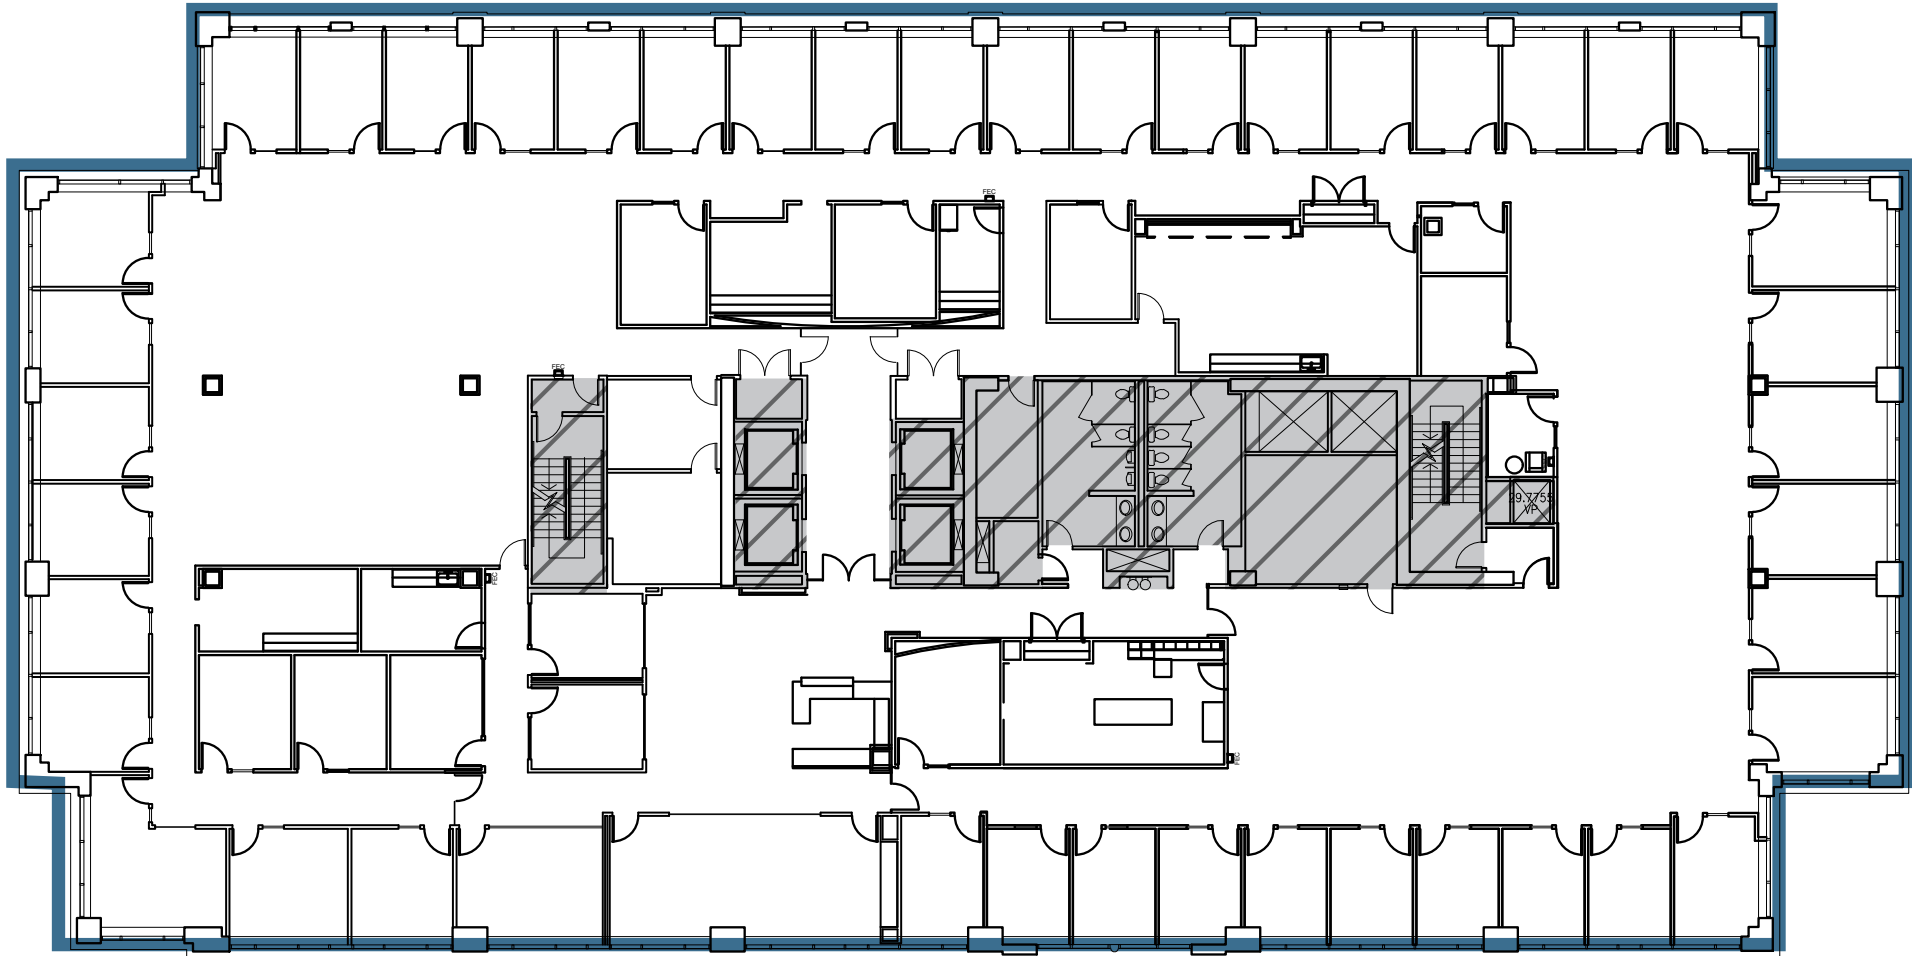

SOUTH TOWER | SUITE 600 | 23,778 RSF

PROPOSED - SINGLE TENANT

