


# BUILDING III

SUITE 120 • 3,872 RSF  
AVAILABLE NOW

*As-Built Floor Plan*

SUNSET  
NORTH

BUILDING III 3180 139TH AVE • BUILDING IV 3150 139TH AVE SE • BUILDING V 3120 139TH AVE SE

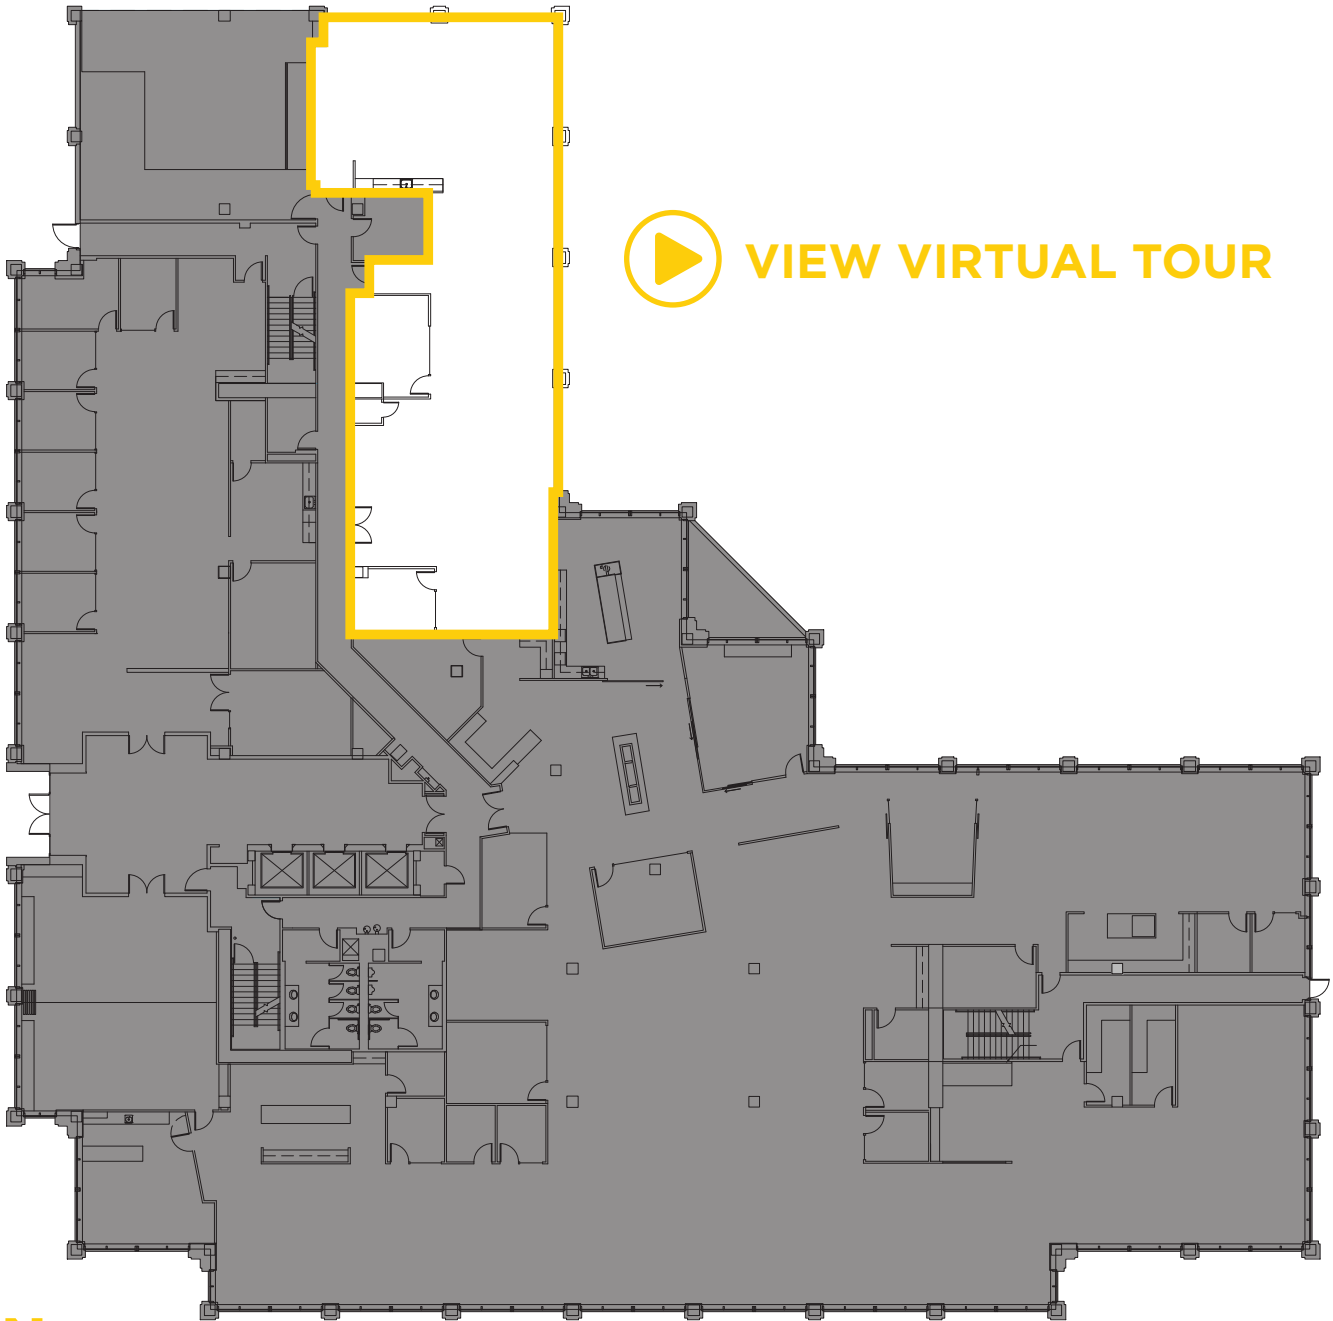

VIEW VIRTUAL TOUR



**BRODERICK GROUP, INC.**

[Jason Furr](#) • [Tony Ulacia](#)

425.646.3444

The information contained herein has been given to us by the owner or sources that we deem reliable. We have no reason to doubt its accuracy, but we do not guarantee it. Prospective tenants should carefully verify all information contained herein.


# BUILDING III

SUITE 120 • 3,872 RSF  
AVAILABLE NOW

*Proposed Layout*

# SUNSET NORTH

BUILDING III 3180 139TH AVE • BUILDING IV 3150 139TH AVE SE • BUILDING V 3120 139TH AVE SE

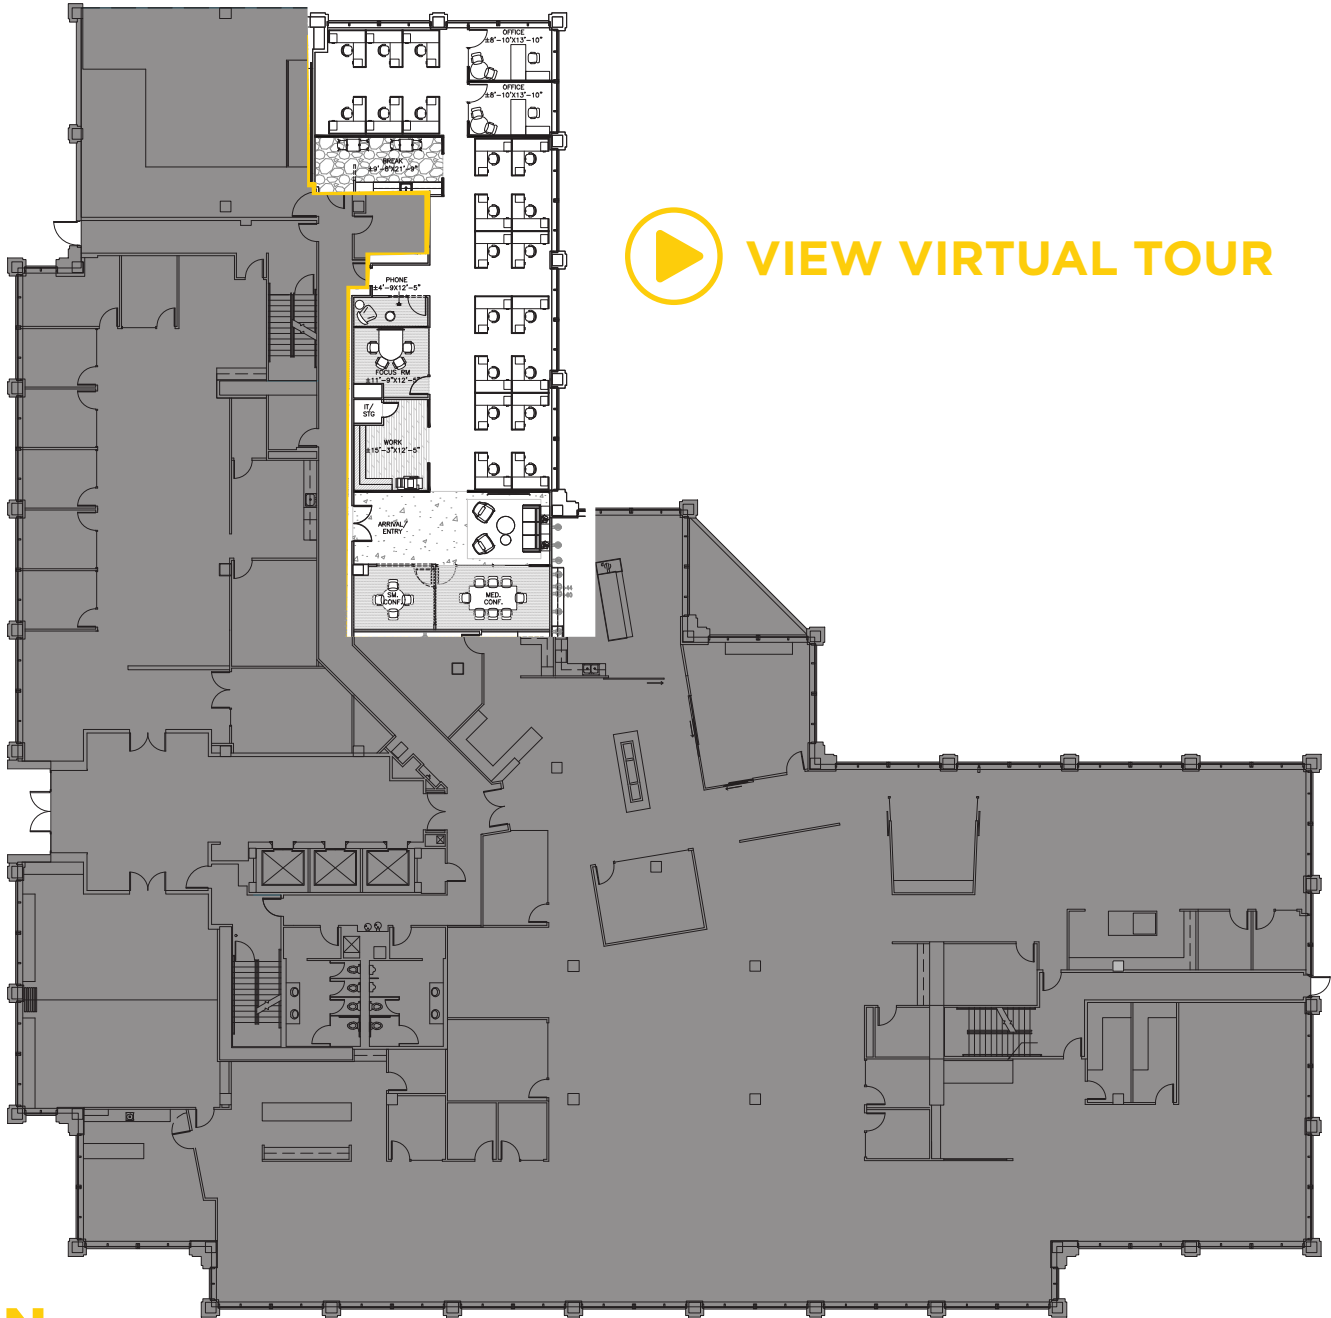

**BRODERICK GROUP, INC.**

[Jason Furr](#) • [Tony Ulacia](#)

425.646.3444

*The information contained herein has been given to us by the owner or sources that we deem reliable. We have no reason to doubt its accuracy, but we do not guarantee it. Prospective tenants should carefully verify all information contained herein.*