
MADISON CENTRE

920 5TH AVENUE | SEATTLE, WA 98104

FLOOR 34 | AS-BUILT

7,936 - 13,998 RSF

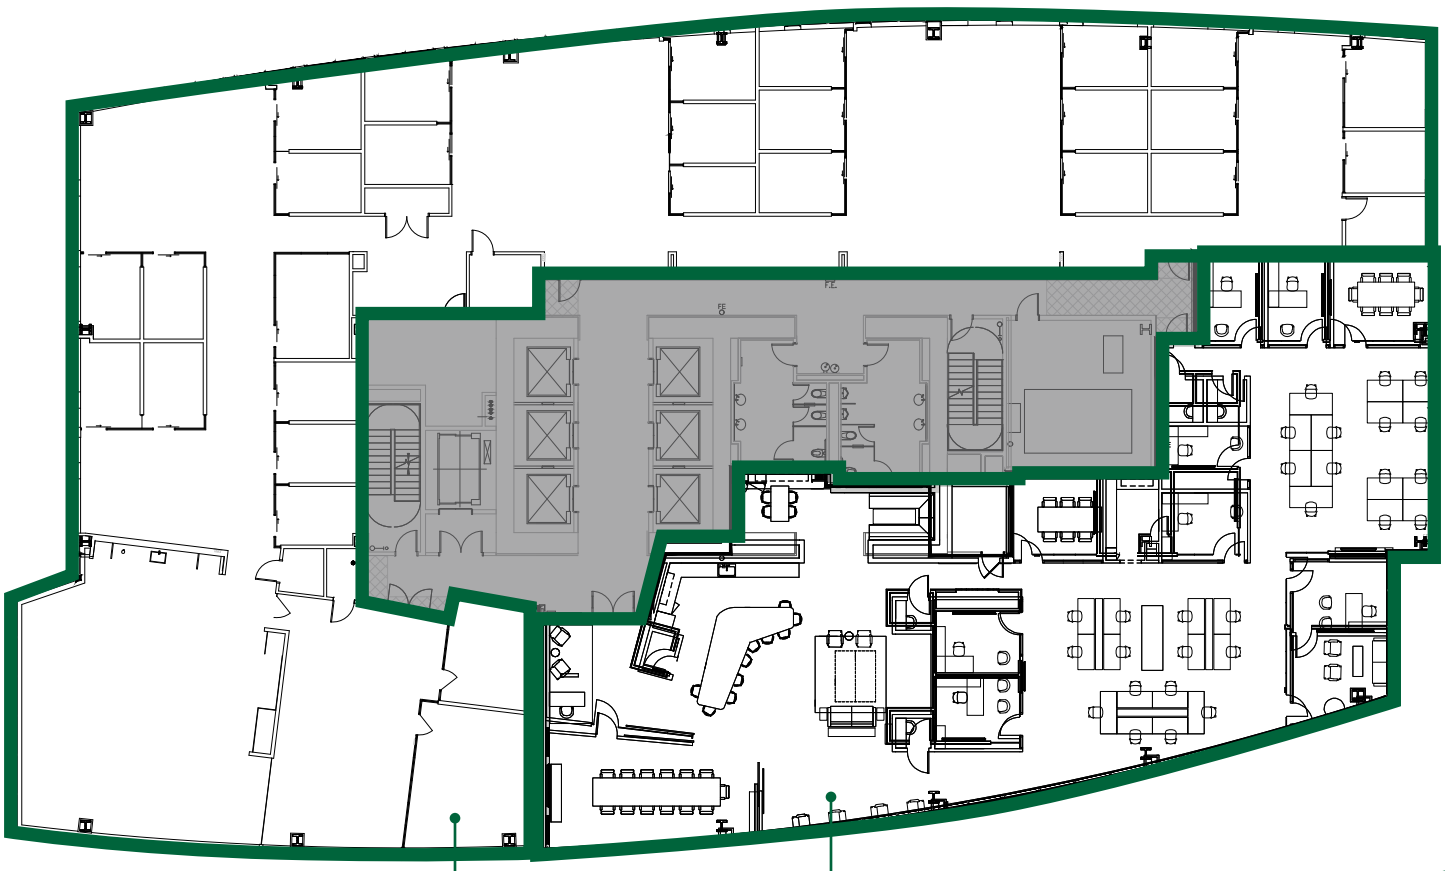

N

SUITE 3400	SUITES 3400 & 3450 CAN BE COMBINED TO CREATE 21,755 RSF	SUITE 3450
13,998 RSF AVAILABLE 10/1/2027		7,936 RSF AVAILABLE NOW FULLY FURNISHED

CLICK TO TAKE A VIRTUAL TOUR

Please contact exclusive leasing agents for more details and to schedule a tour.

DAMON MCCARTNEY | (206) 838-7633
mccartney@broderickgroup.com

DAVID GREENWOOD | (206) 838-7635
greenwood@broderickgroup.com

bxp

BRODERICK · GROUP ·